


IMPROVEMENT SURVEY

CURVE DATA

C1	C4
$\Delta = 02^{\circ}05'53''$	$\Delta = 02^{\circ}06'07''$
$R = 2,700' (2700')$	$R = 2,590' (2590')$
$A = 99.04' (99.03')$	$A = 95.17' (95')$
$C = 99.05'$	$C = 95.16'$
@ N 34°00'19"E	@ S 34°26'40"W

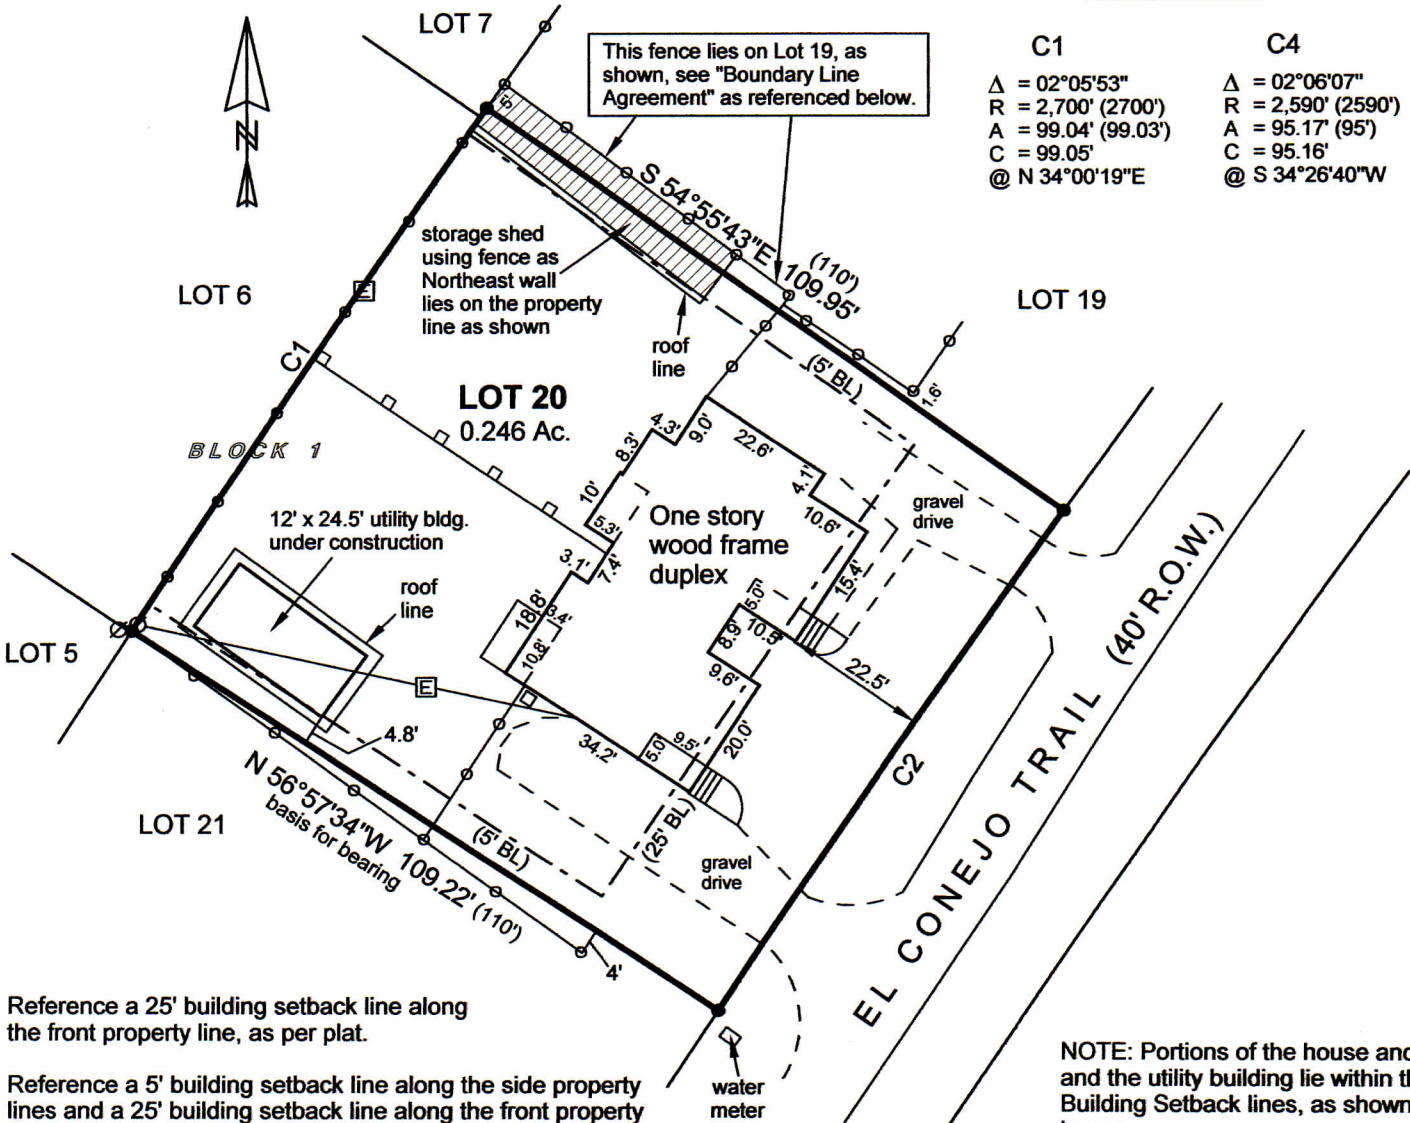

Reference a 25' building setback line along the front property line, as per plat.

Reference a 5' building setback line along the side property lines and a 25' building setback line along the front property line, as per plat and according to the restrictions recorded in Volume 144, Page 210, Volume 271, Page 145, Volume 271, Page 719, Hays County Deed Records, and Volume 436, Page 775, Hays County Real Property Records.

Reference a 10' wide utility easement, the centerline being the pipeline as installed, granted to Wimberley Water Supply Corporation, as recorded in Volume 210, Page 127, Hays County Deed Records.

Reference a 15' wide utility easement, the centerline being the pipeline as installed, granted to Wimberley Water Supply Corporation, as recorded in Volume 2534, Page 897, Hays County Official Public Records.

Reference a blanket utility easement granted to Pedernales Electric Cooperative, Inc., as recorded in Volume 157, Page 9, Hays County Deed Records.

Reference a "Boundary Line Agreement", as recorded in Volume 3199, Page 263, Hays County Official Public Records,

NOTE: Portions of the house and the utility building lie within the Building Setback lines, as shown hereon.

- = 1/2" iron pin found unless otherwise noted
- BL = building setback line
- (XXXX) = recorded data
- = wood fence
- = cedar post fence
- E— = overhead electric line
- Ø = utility pole

Copyright © 2018 Eagle Land Surveying. All rights reserved.

LEGAL DESCRIPTION: All of Lot 20, Block 1, EAGLE ROCK RANCHITOS, a subdivision in Hays County Texas, according to the map or plat thereof recorded in Volume 144, Page 165, Deed Records of Hays County, Texas.


ADDRESS: 16 El Conejo Trail, Wimberley, Texas 78676

CLIENT: Rebekah R. Cleckler TITLE COMPANY: Independence Title Company
G.F. No.: 1840488-WIM

I hereby certify that this plat represents a survey made upon the ground under my supervision, on November 6, 2018, and that there are no visible or apparent encroachments upon this property, except as shown hereon.

Clyde Barroso

Clyde Barroso, R.P.L.S. #5404, State of Texas, Firm #10079300.

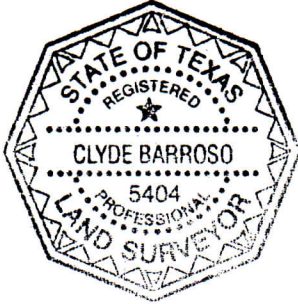

EAGLE
LAND
SURVEYING
(512) 847-1079
P.O. Box 2264 Wimberley, TX. 78676

Scale:
1" = 30'

Date:
November 6, 2018

Job No. 18-110 jj/cb

16conejo.ZAK